

HÖHENANGABEN VON AUSSPARUNGEN IM ZWG BE-
ZIEHEN SICH AUF OK FFB +3.167

4. 3. 88	Chabulgo
----------	----------


geprüft auf Übereinstimmung mit der Ausführungsplanung. 1578

OBJEKTVERROHRUNG NUR NACH

Legende

**STADTWERKE FRANKFURT AM MAIN
NEUBAU KUNDENZENTRUM BÖRSEPLATZ**

DIE BAUHERRSCHAFT:

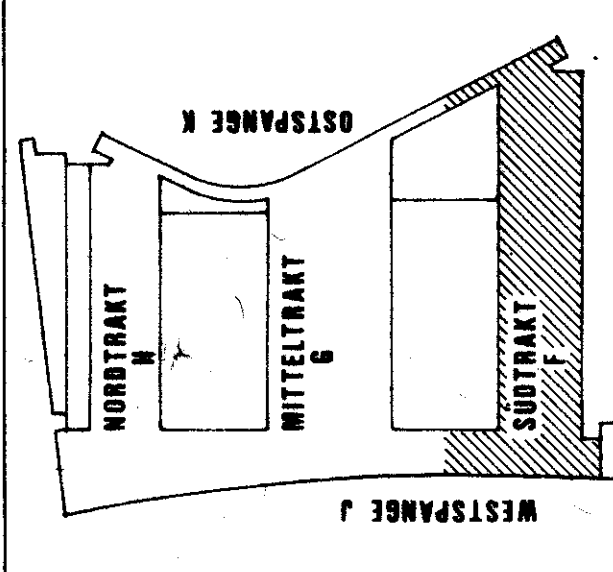

FRANKFURT M. DEN

NO. 150 / 071r		MST. 1:50	
DATE	28.01.97	PI GR	90 / 210
		G57 A	

BESTANDSPLAN

um	Änderung	Name
= & CO		Heizung - Lüftung - Sanitär
CO KG		Große Seestraße 32-34
		Frankfurt/M. Tel. 089/77 05 46

NKR

1.06, Südtrakt C (Achse 10 - 17)

E. GISEL ARCHITEKT BSA BDA CH-8032 ZÜRICH
TEL. ZH: 0041 1 55 19 44 TEL. F: 069 1368 2686

BAULEITUNG: FRANKFURTER AUFBAU AG TEL. 069 2698 396

Architectural floor plan of a long building, oriented vertically. The plan shows a central corridor with rooms on both sides. At the top, there is a section labeled '0' and a small detail of a room with a door. Below this, the main corridor runs vertically. On the left side, there are several rooms, some with doors and some with windows. On the right side, there are more rooms and a large open area. The plan includes dimensions and labels for various parts. At the bottom, there is a section labeled '0' and a small detail of a room with a door. The plan is titled 'GRUNDRISS AUF KOTE +3.50' and 'SEHE PLNR. 150/134. 3251'.

Kämpf&CO: Planänderung

10 11 12 13 14 15 16 17